

**GEOMETRIC LEGEND**


--- EXISTING GEOMETRICS  
--- PROPOSED GEOMETRICS

**UTILITY LEGEND**

--- G GAS MAIN  
--- W WATER MAIN  
--- S SEWER MAIN  
--- E ELECTRIC CABLES  
--- A AERIAL CABLES  
--- T TELEPHONE CABLES

- aa. INSTALL WHITE LEAD FREE THERMOPLASTIC PAVEMENT MARKING YIELD LINE.
- bb. INSTALL 20 FT. LIGHTING ARM WITH A 250 WATT HIGH PRESSURE SODIUM VAPOR LUMINAIRE ON PROPOSED BGE POLE.
- cc. INSTALL 10 IN. WHITE LEAD FREE THERMOPLASTIC PAVEMENT MARKING (3'-9"-3').
- dd. INSTALL GROUND MOUNTED SIGN WITH 4 IN. X 4 IN. WOOD SIGN SUPPORT.
- ee. INSTALL 10 FT. PEDESTRIAN POLE, CUT CLEAN AND GALV. TO 4 FT., WITH APS PUSHBUTTON AND PEDESTRIAN EDUCATION SIGN. (NOTE: 1-2 IN. SCHEDULE 80, 90-DEGREE POLYVINYL CHLORIDE CONDUIT BEND)

- SPECIAL NOTES**
1. FOR MOUNTING PROPOSED SIGNS M95-1 MOD TO THE SIGNAL MAST ARMS DIAGONALLY USE SHA STANDARD "SIGN MOUNTING ON DIAGONAL MAST ARMS" TYPICAL NO. 813.99.05.
2. INSTALL OBJECT MARKERS, (OM-1(1)), AT THE APPROACH NOSE OF ALL CONCRETE ISLANDS.

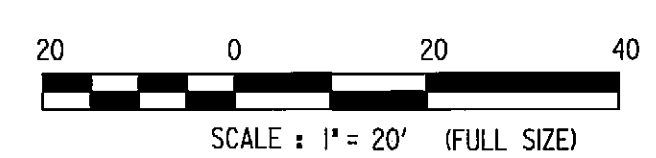

PREPARED BY  
**URS**  
HUNT VALLEY, MARYLAND

APPROVALS	REVISIONS
TEAM LEADER	
ASST. DIV. CHIEF	
DIVISION CHIEF	
OFFICE DIRECTOR	
	(B) RECONSTRUCT SIGNAL DUE TO NEW GEOMETRICS HO. CO. CAPITAL PROJECT J-1118 KJS
	A 5189 ASBUILT INSTALL EP LEFT TURN PHASE FOR WB MD 175 DCD

**SHA**STATE OF MARYLAND  
DEPARTMENT OF TRANSPORTATION  
STATE HIGHWAY ADMINISTRATION  
OFFICE OF TRAFFIC & SAFETY  
TRAFFIC ENGINEERING DESIGN DIVISION

TRAFFIC SIGNAL PLAN  
MD 175 (WATERLOO RD.) &  
DORSEY RUN RD

SCALE 1" = 20' DATE 9-14-79 CONTRACT NO. H0559501785

DESIGNED BY M. GESELL COUNTY HOWARD  
DRAWN BY M. G. D. LOGMILE 13017500.24  
CHECKED BY H. J. A. T.I.M.S. NO. H362  
F.A.P. NO. N/A TOD NO.

DRAWING NO. TS 17318 SHEET NO. 1 OF 2

Q:\20829544\CAD\G-07\TS17318.dgn